











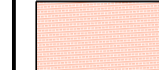






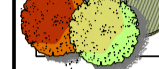



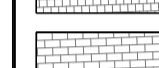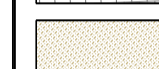


North

Legend.

-  Red line boundary
-  Lawn
-  Shrub planting
-  Hedge planting
-  Specimen tree planting
-  Street trees in hardstand areas
-  Concrete path
-  Tarmac Road
-  Permeable Concrete paving
-  Granite Setts
-  Precast Concrete Flags
-  Ballylusk compacted gravel
-  Asphalt surface finish with paving and Limestone edge(fire tender route)
-  Cycle lane
-  Safety surface
-  Seating
-  Reinforced grass / ground
-  Vent locations - Refer to Architects drawings for details
-  1.20m high metal railing to courtyards
-  Root barrier, 1.0m depth
-  Swale / Bioretention tree pit
-  6 Nr. woodcrete bat box
-  Possessory strip
-  Landscape areas revised in line with Retail block amendments.

Rev	Date	Note

Project name: Rathborne 725 Block A Substation LRD Amendment	Project number: 19-013
Drawing name: Block A Landscape Plan	Drawing number: LP-20-PP

Drawing scale @ A1: 1:250	Drawn by: kg	Checked by: d+ot
Status: Planning	date: 2024-05-15	


Contact details: Linda Doyle (Director) mobile: 087 287 4196 e-mail: linda@doyle-otroith.com Sue O'Troith (Director) mobile: 086 200 3499 e-mail: sue@doyle-otroith.com	Office address: Parrucke House 28-32 Upper Parrucke Street DUBLIN 2
---	--

doyle + o'troith
landscape - architecture



Royal Canal - An Chanáil Ríoga

Granted Planning Application

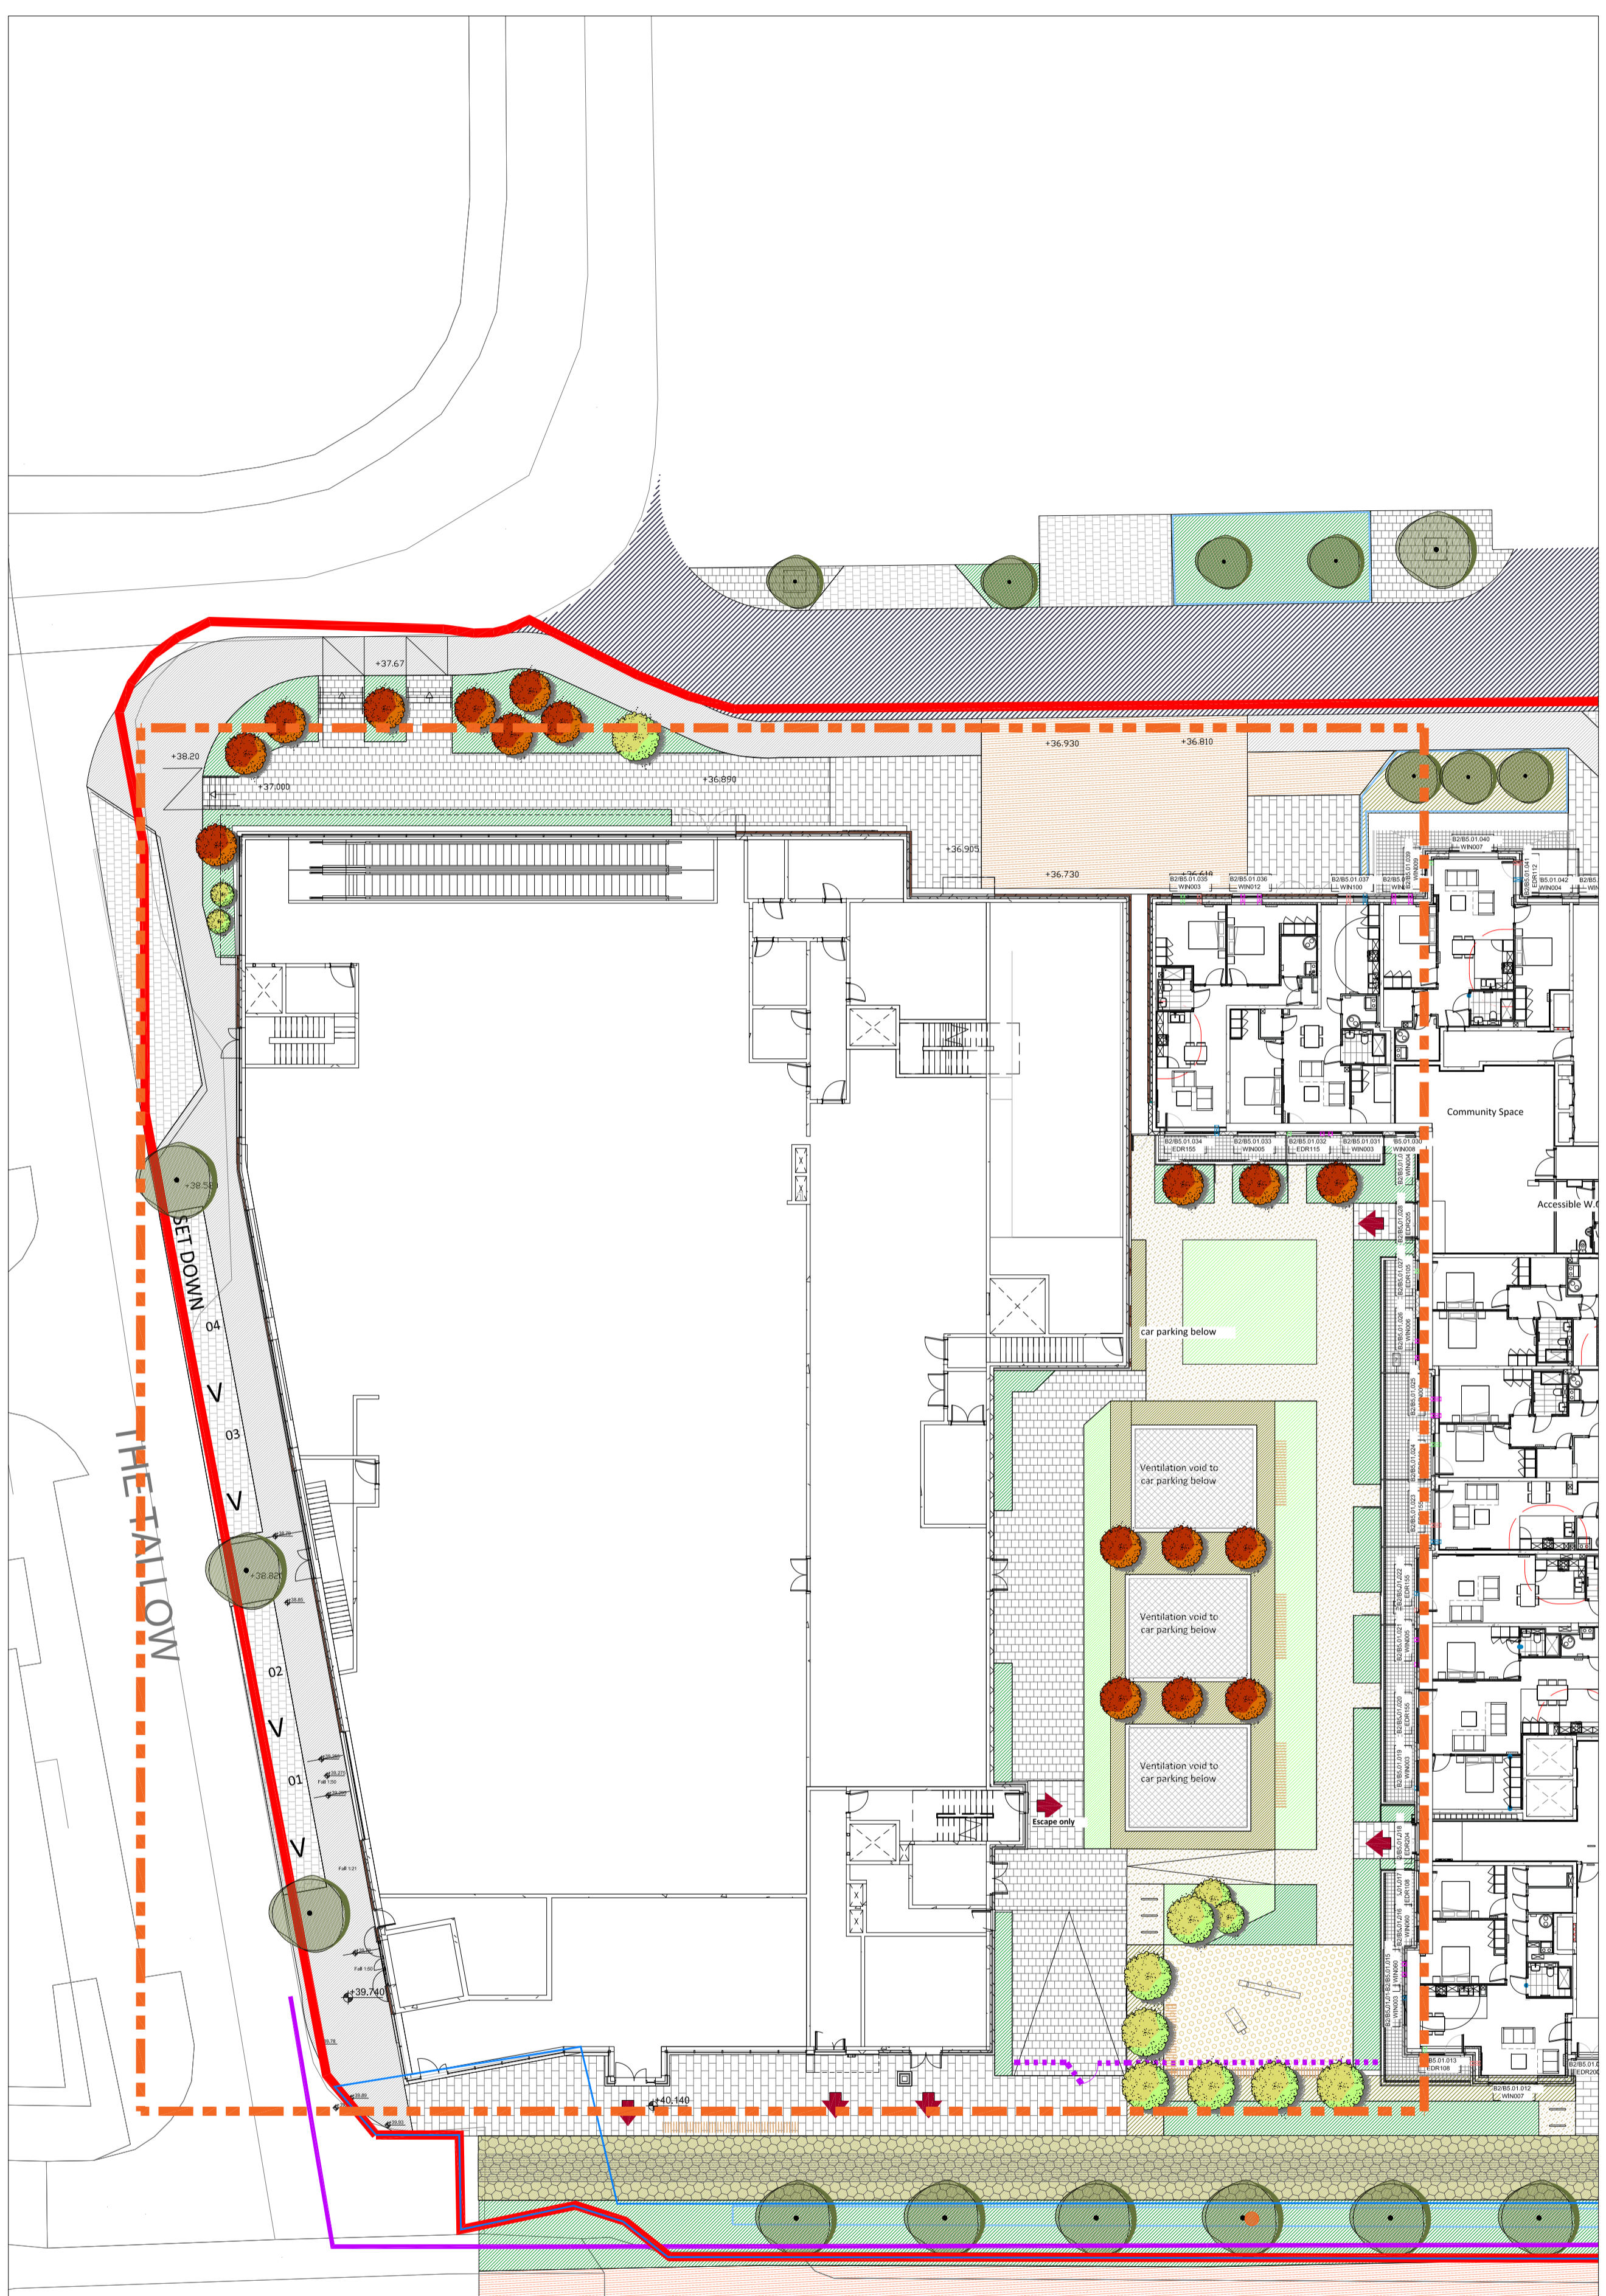

Royal Canal - An Chanáil Ríoga

Amendment Planning Application