



1 Pro_Site Plan - Podium Level
1 : 500


Red line indicates site under application.
Area outlined in green indicates 92 houses granted under application DCC Reg. Ref-3666/15

Site Plan - Podium Level - Proposed

Extent of Proposed Amendments Outlined with a Green Dashed Line

Refer to the Landscape Drawing 19-013-LP-20-PP

OSi Licence No. CYAL50312946
OS MAP Site Coordinates: 713604, 738373
Map Sheets 3196-10, 3196-04, 3196-09, 3196-05
Datum: Malin Head

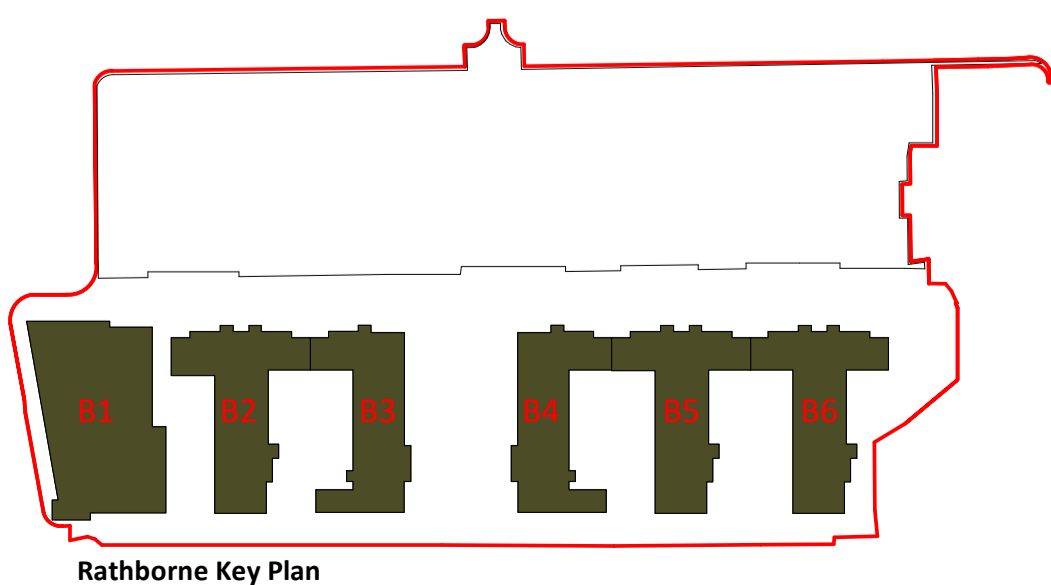

Revision Description	Date	Rev. No.	Issued by
For Planning - Amended	31/05/23	C01	AT
Rathborne LRD Amendments	09/08/23	C02	AT
For Information - Rathborne B1 Amendments	18/04/24	P01	AT
For Information - Rathborne B1 Amendments	22/04/24	P02	AT
For Information - Rathborne B1 Amendments	24/04/24	P03	AT
Rathborne B1 Amendments	17/05/24	C03	AT

Any reference to fire safety design or performance is presented for coordination purposes only. Refer only to the granted Fire Safety Certificate, and fire consultant's information for fire safety design, specification and performance.
Figured dimensions only to be used. This drawing is copyright of O'Mahony Pike Architects Ltd. All information is shared as per approved use in accordance with ISO19650-2:2018, Table 5; Standard Codes for Suitability of Models and Documents and the BEP. If the 'Status' field is empty, this information has been shared at 50 - WIP.

omahony pike

architecture | urban design | Dublin | Cork
 email: info@omahonypike.com | The Chapel | One South Mall
 tel: +353 1 202 7400 | Mount St. Anne's | Cork City
 fax: +353 1 283 0822 | Milltown, Dublin 6 | Co. Cork
 www.omahonypike.com | D06 XN52 Ireland | T12 CCN3 Ireland

Project Code: 19016A
 Project Lead: EM
 Drawn By: CM
 Job No.: 19016A
 Purpose: Planning

Scale @ A1: As indicated
 Date: 17/05/24
 Revision: C03
 Status: A3

Project: Rathborne 725 Block A Substation LRD Amendment
 Location: Rathborne, Dublin 15
 Client: Ruisside Developments Limited

Drawing Title: Site Plan - Podium Level - Proposed
 Drawing No.: 19016A-OMP-ZZ-01-DR-A-1102

Source File: 19016A-OMP-ZZ-01-DR-A-1102.rvt